


**Bevois Town Primary School
Year 5 & 6 Building
Water System Drawings
25th January 2017**

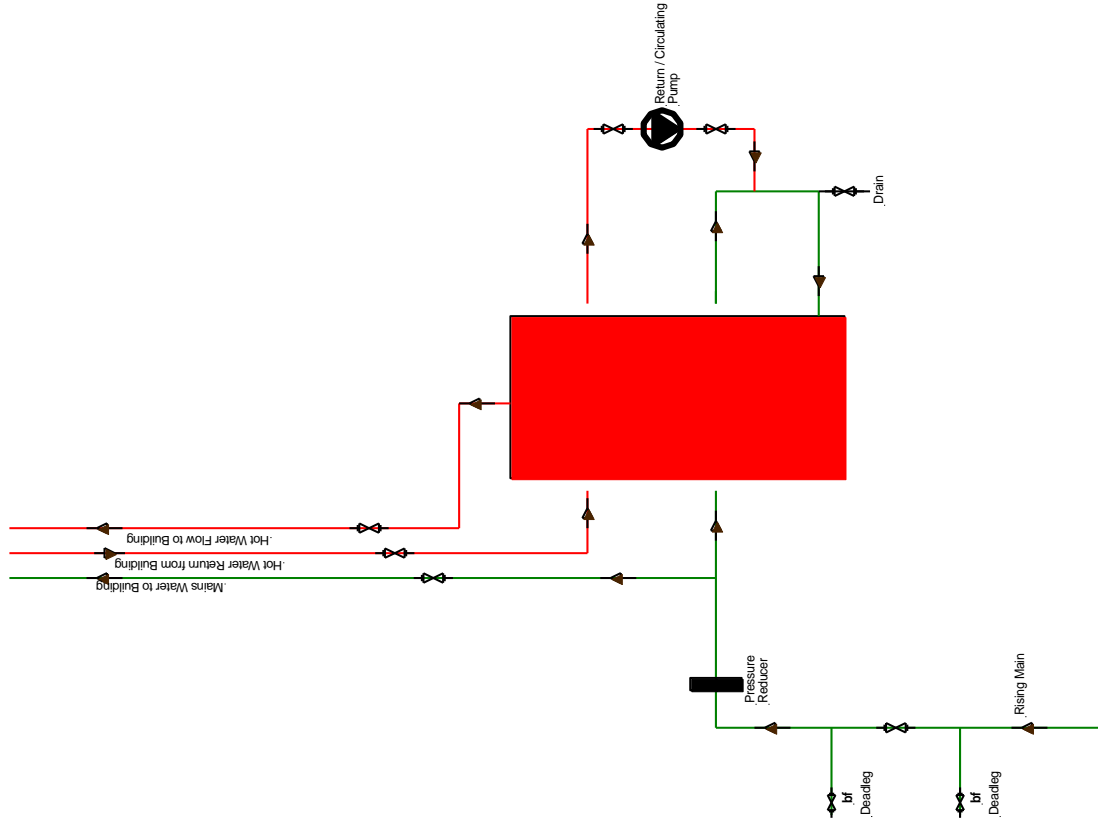

This drawing was prepared for the Legionellosis Risk Assessment Report and not intended as a sealed system drawing. Drawings are based on a visual inspection carried out during the supply. Some areas of pipe work may not have been visible during the survey therefore some assumptions may have been made in order to create this drawing.


This drawing is not to scale

Symbol	Description
WM	Washing Machine
WB	Wash Basin
SK	Sink
WC	Toilet
SH	Shower
DW	Dishwasher
UR	Urinal
WH	Water Heater
POUMH	Point Of Use Water Heater
TWV	Thermostatic Mixing Valve / Blender Valve
Green line	Mains Water
Blue line	Down Service
Red line	Hot Water
Blue line	Softened Water



Freeston Water Treatment
 Unit 1 North Business Centre
 Calmore Industrial Estate
 Totter Southampton
 SO40 3WW
 Tel: 02380668713

Site Reference / Date : 25th January 2017
 Bevois Town Primary School
 New Building Plant Room
 Domestic Water Systems Layout

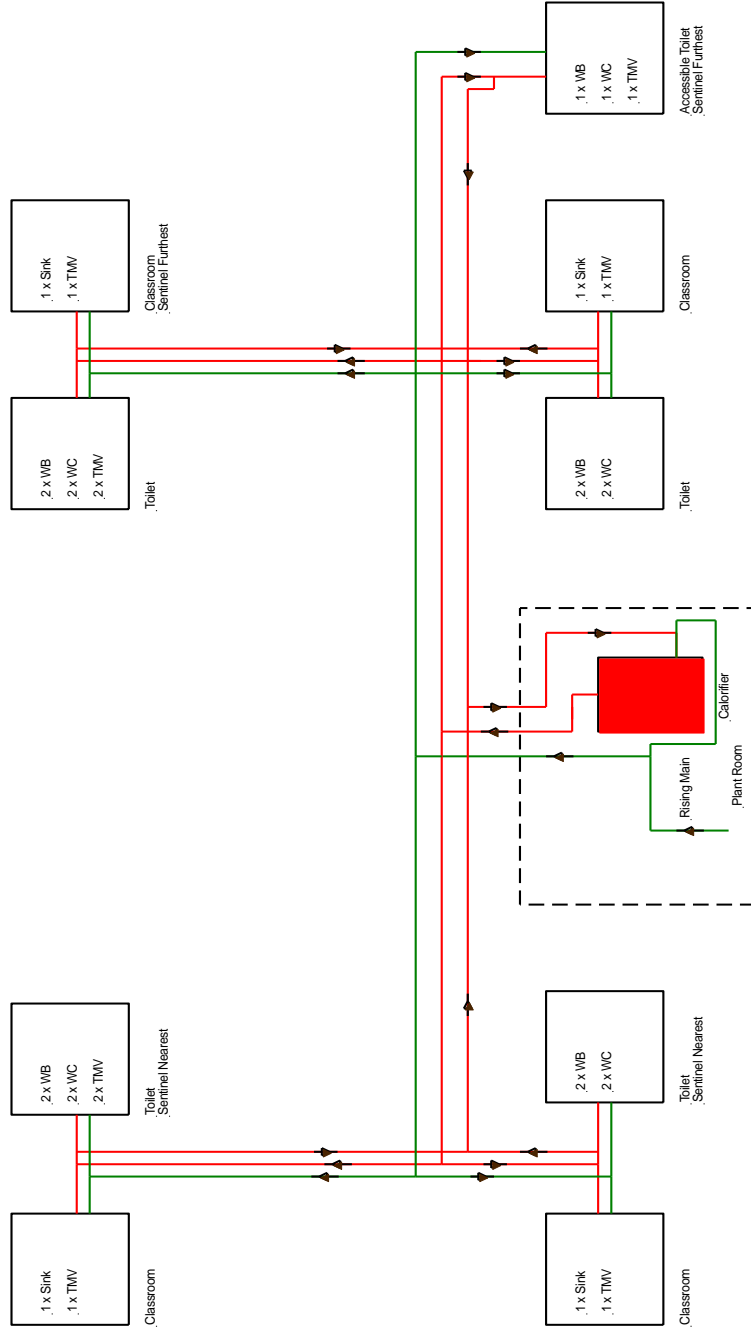

Site Reference/Date : 25th January 2017
 Bevois Town Primary School
 New Building Water System Layout

Freeston Water Treatment
 Lulworth Business Centre
 Gannore Industrial Estate
 Totton Southampton
 SO40 3WW
 Tel: 02380689713

FREESTON
 Water Treatment

This drawing was prepared for the Legionellosis Risk Assessment Report and not intended as a scaled system drawing. It is a schematic drawing and is not intended to be used for construction purposes. Some areas of pipe work may not have been viable during the survey therefore some assumptions may have been made in order to create this drawing.

This drawing is not to scale

.WM = Washing Machine	DW = Dishwasher	.Mains Water
.WB = Wash Basin	.UR = Urinal	.Down Service
.SK = Sink	.WH = Water Heater	.Hot Water
.WC = Toilet	.POUWH = Point Of Use Water Heater	.Softened Water
.SH = Shower	.TMV = Thermostatic Mixing Valve / Blended Valve	