


Sembal House
Water System Drawings
16th August 2017

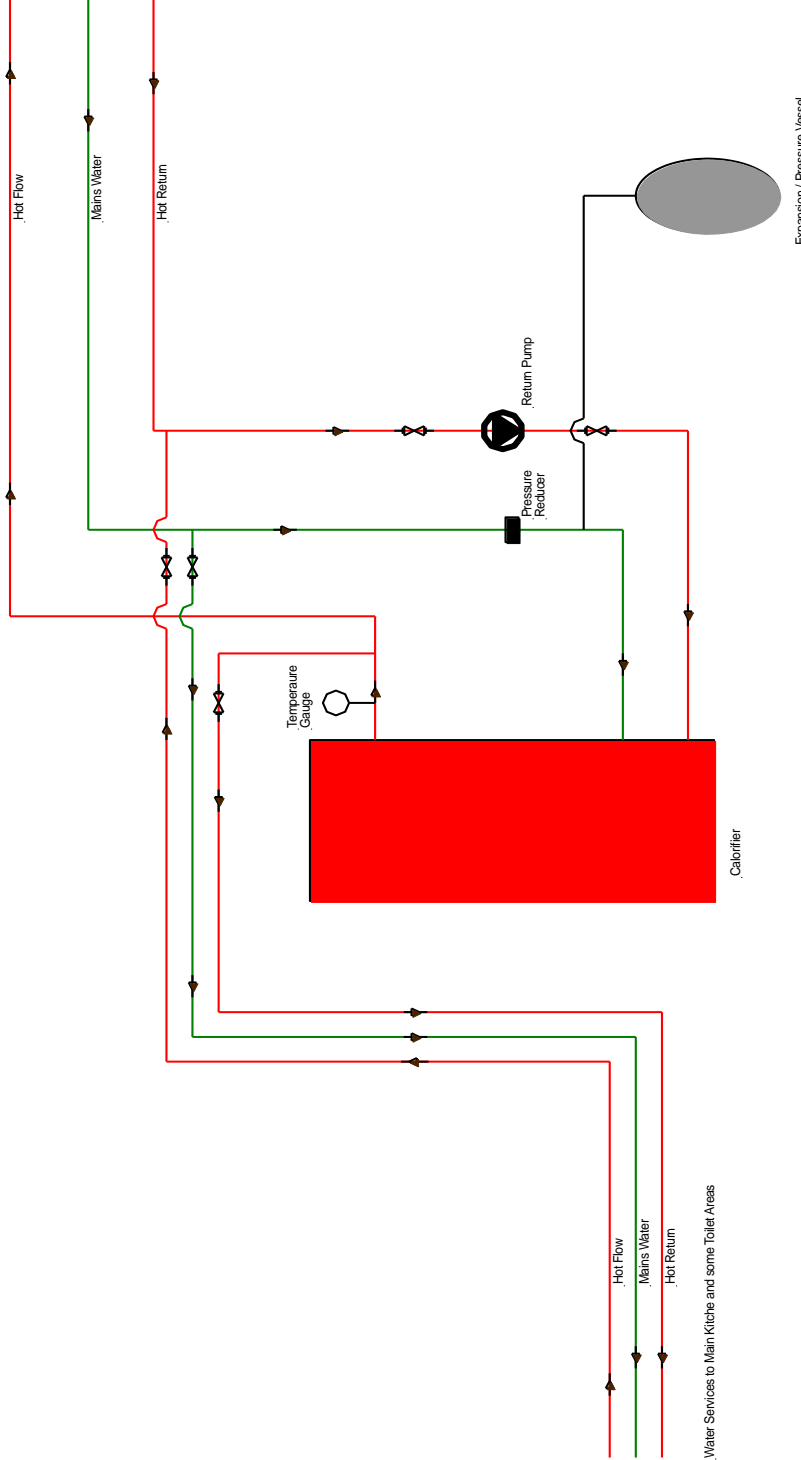

Site Reference / Date
 Sembal House
 Hot Water Calorifier System Plant Room Area
 16th August 2017


FREESTON
 Water Treatment

Freeston Water Treatment
 Lulworth Business Centre
 Calmore Industrial Estate
 Totton Southampton
 SO40 3WW
 Tel 0238068713

This drawing was prepared for the Legionellosis Risk-Assessment Report and not intended as a scaled system drawing. It is based on the information available during the Risk Assessment and information given at the time of the survey. Some areas of pipe work may not have been visible during the survey therefore some assumptions may have been made in order to create this drawing.
 This drawing is not to scale

LEGEND

WM = Washing Machine	DW = Dishwasher	Green line	Mains Water
WB = Wash Basin	UR = Urinal	Blue line	Down Service
SK = Sink	WH = Water Heater	Red line	Hot Water
WC = Toilet	POUWH = Point Of Use Water Heater	Green line with red top	Softened Water
SH = Shower	TWV = Thermostatic Mixing Valve / Blender Valve		

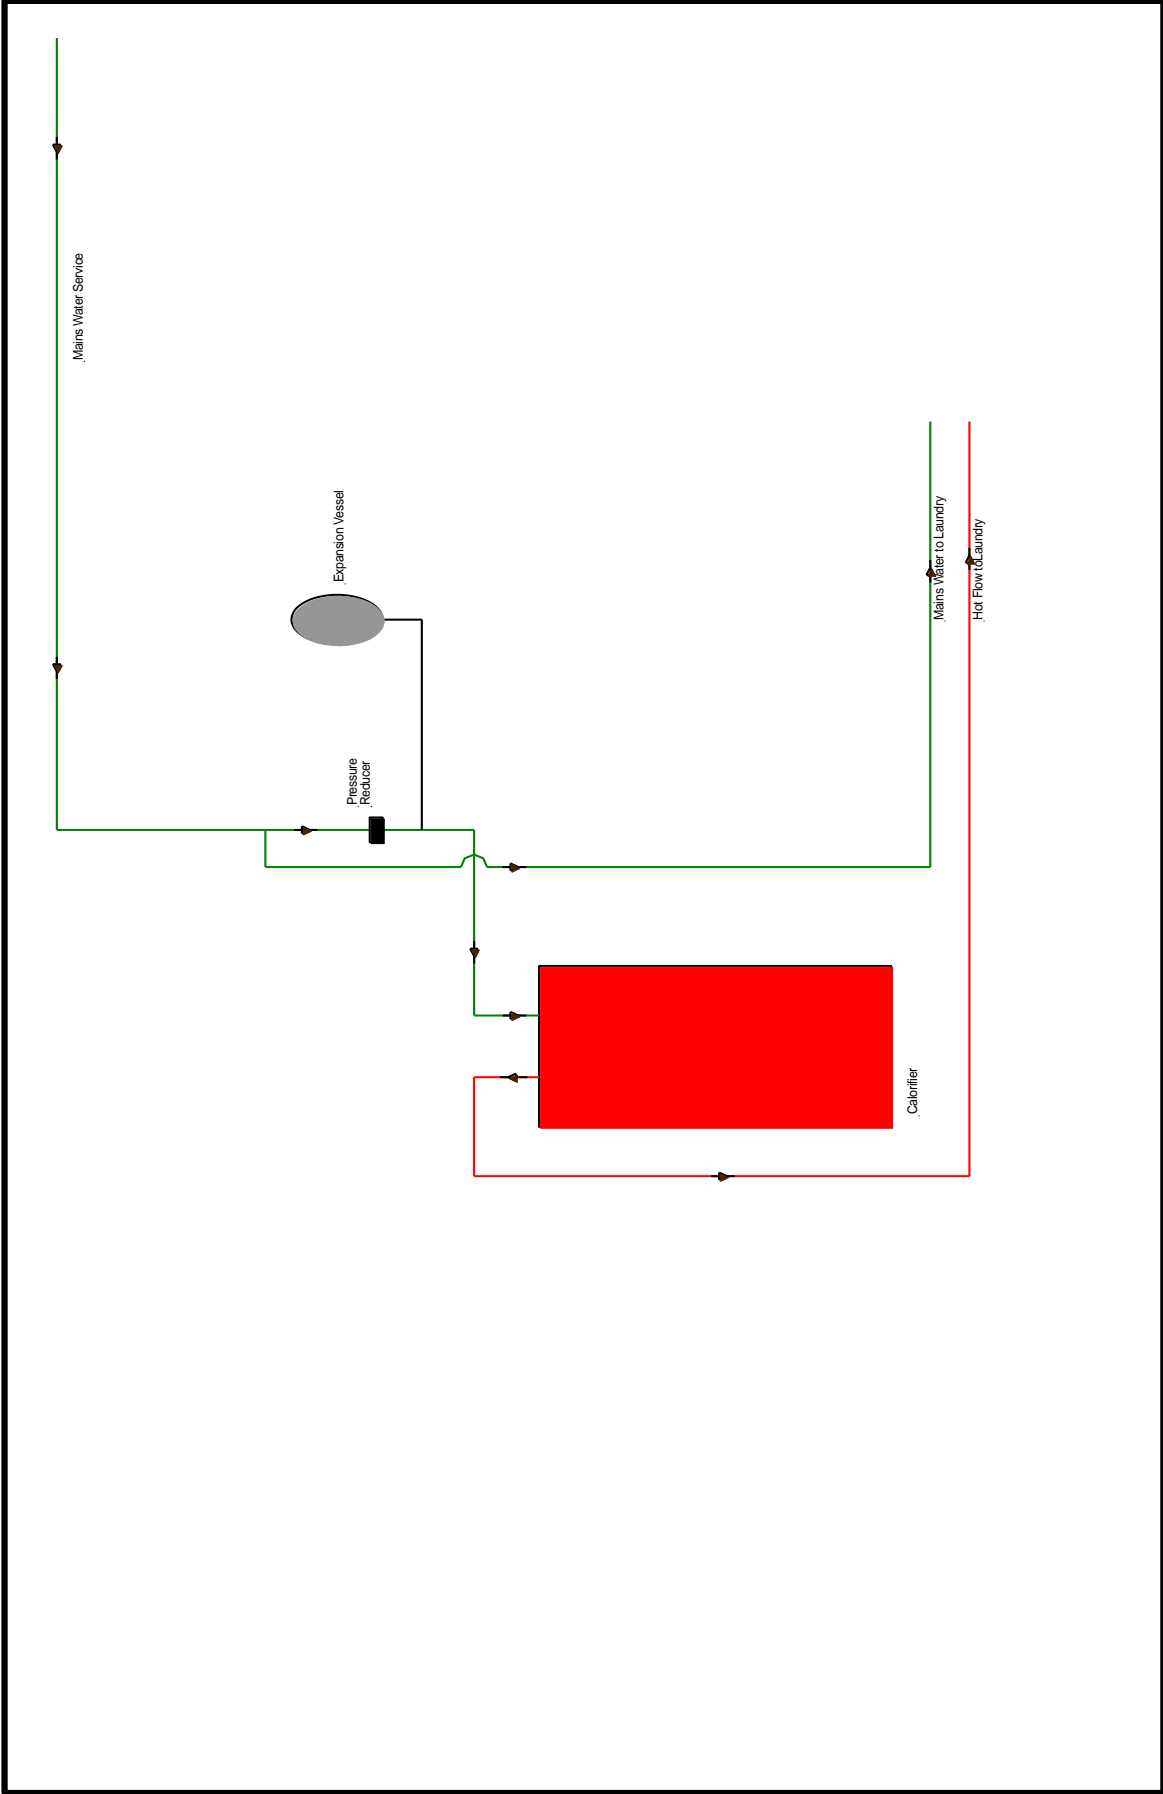


LEGEND

.WM = Washing Machine	DW = Dishwasher	.Mains Water	Freeston Water Treatment	Site Reference / Date
.WB = Wash Basin	.UR = Urinal	.Down Service	Lilworth Business Centre	Sembal House
.SK = Sink	.WH = Water Heater	.Hot Water	Calmore Industrial Estate	.Hot Water Calorifier serving Laundry
.WC = Toilet	.POUWH = Point Of Use Water Heater	.Softened Water	Totton Southampton	.16th August 2017
.SH = Shower	.TMV = Thermostatic Mixing Valve / Blender Valve		SO40 3WW	
			Tel 0238068713	

This drawing was prepared for the Legionellosis Risk-Assessment Report and not intended as a scaled system drawing. It is a schematic diagram and does not show the exact location of components. During the Risk Assessment and installation, it is the responsibility of the contractor to ensure that the system is installed in accordance with the survey. Some areas of pipe work may not have been viable during the survey therefore some assumptions may have been made in order to create this drawing.

FREESTON
Water Treatment

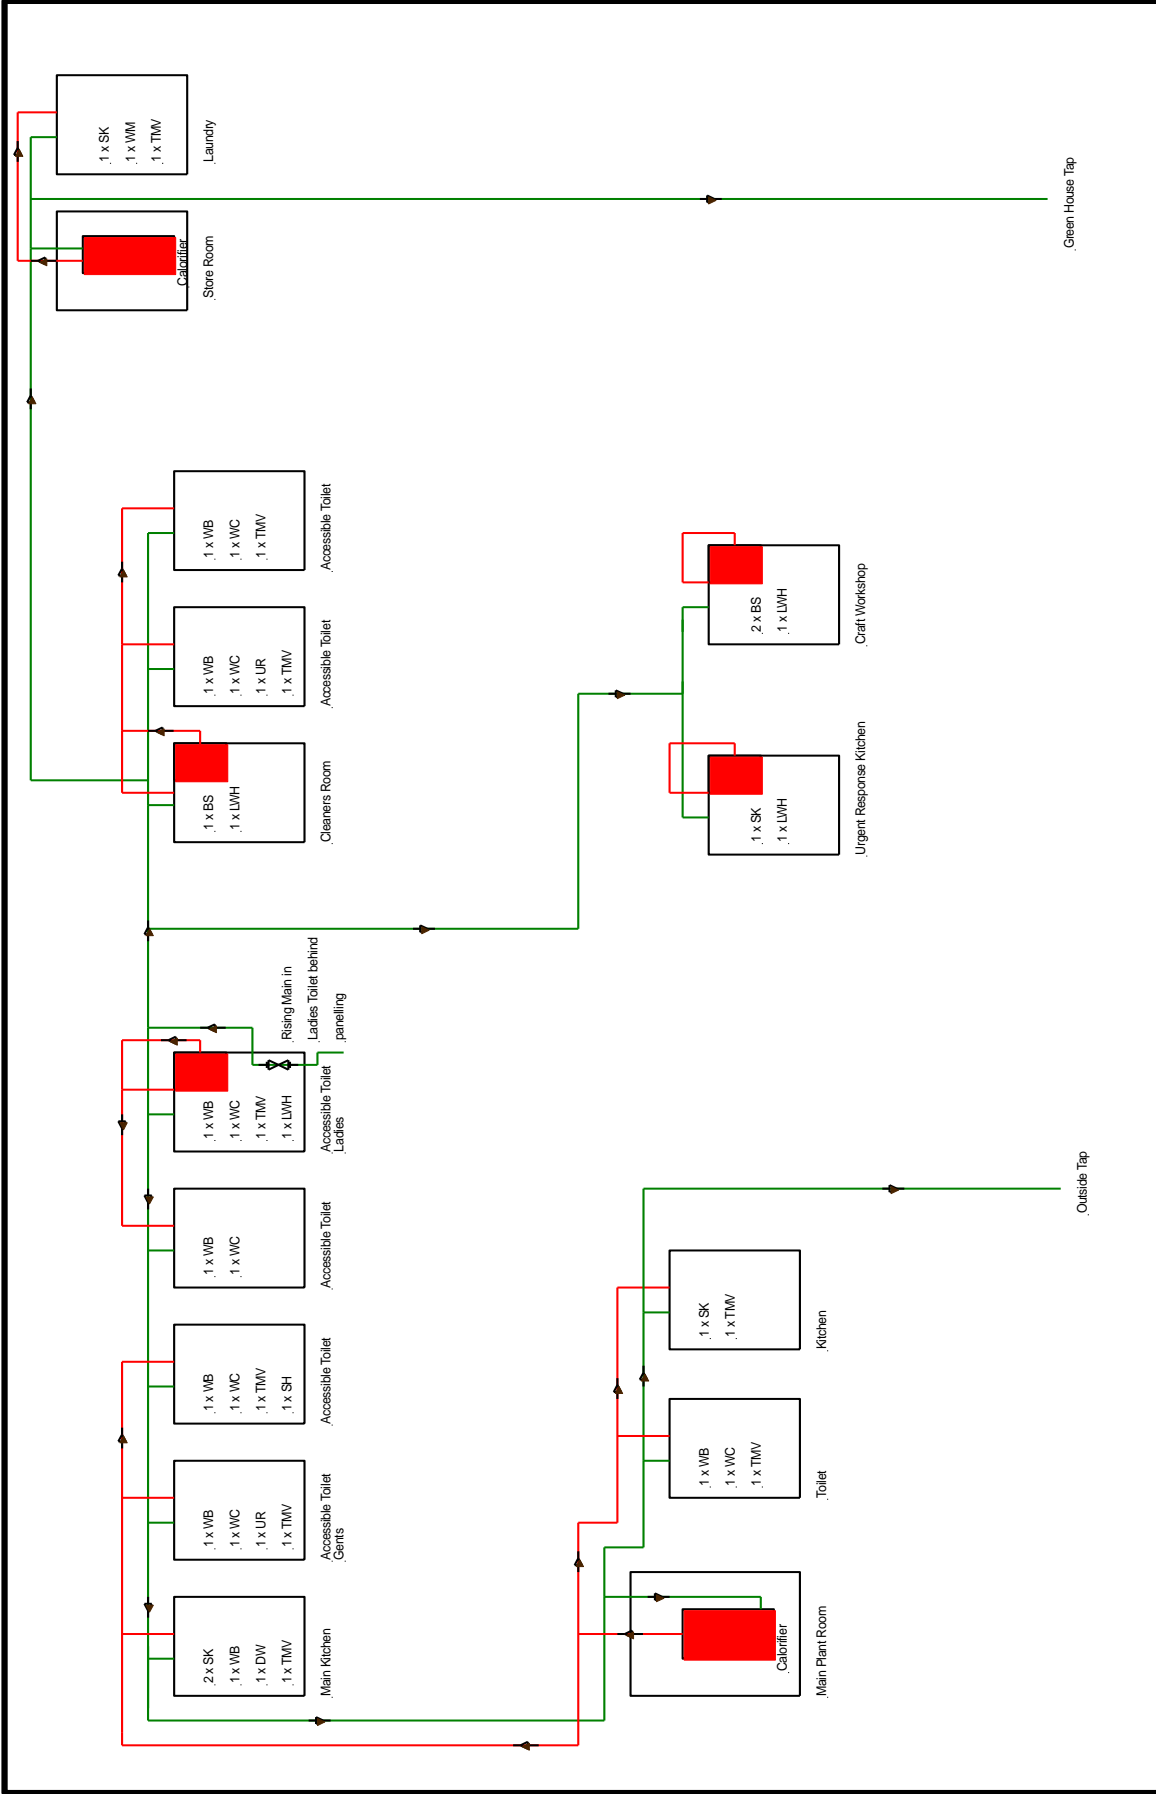

LEGEND

- WM = Washing Machine
- WB = Wash Basin
- SK = Sink
- WC = Toilet
- SH = Shower
- DW = Dishwasher
- UR = Urinal
- POUWH = Point Of Use Water Heater
- TMV = Thermostatic Mixing Valve / Blender Valve
- BS = Butler Sink
- LWH = Local Water Heater

This drawing was prepared for the Legionellosis Risk-Assessment Report and not intended as a scaled system drawing. It is for information only and is not to be used for construction. Some areas of pipe work may not have been visible during the survey therefore some assumptions may have been made in order to create this drawing.

LEGEND

- Green line = Mains Water
- Blue line = Down Service
- Red line = Hot Water
- Green line with arrow = Softened Water

Site Reference / Date
 Sembal House
 Domestic Water System Layout
 16th August 2017

FREESTON
 Water Treatment

Freeston Water Treatment
 Lulworth Business Centre
 Calmore Industrial Estate
 Totton Southampton
 SO40 3WW
 Tel 02380669713

Outside Tap