


**Woolston  
Community Centre  
&  
Pre-School**

**Water System Drawings  
16<sup>th</sup> January 2017**

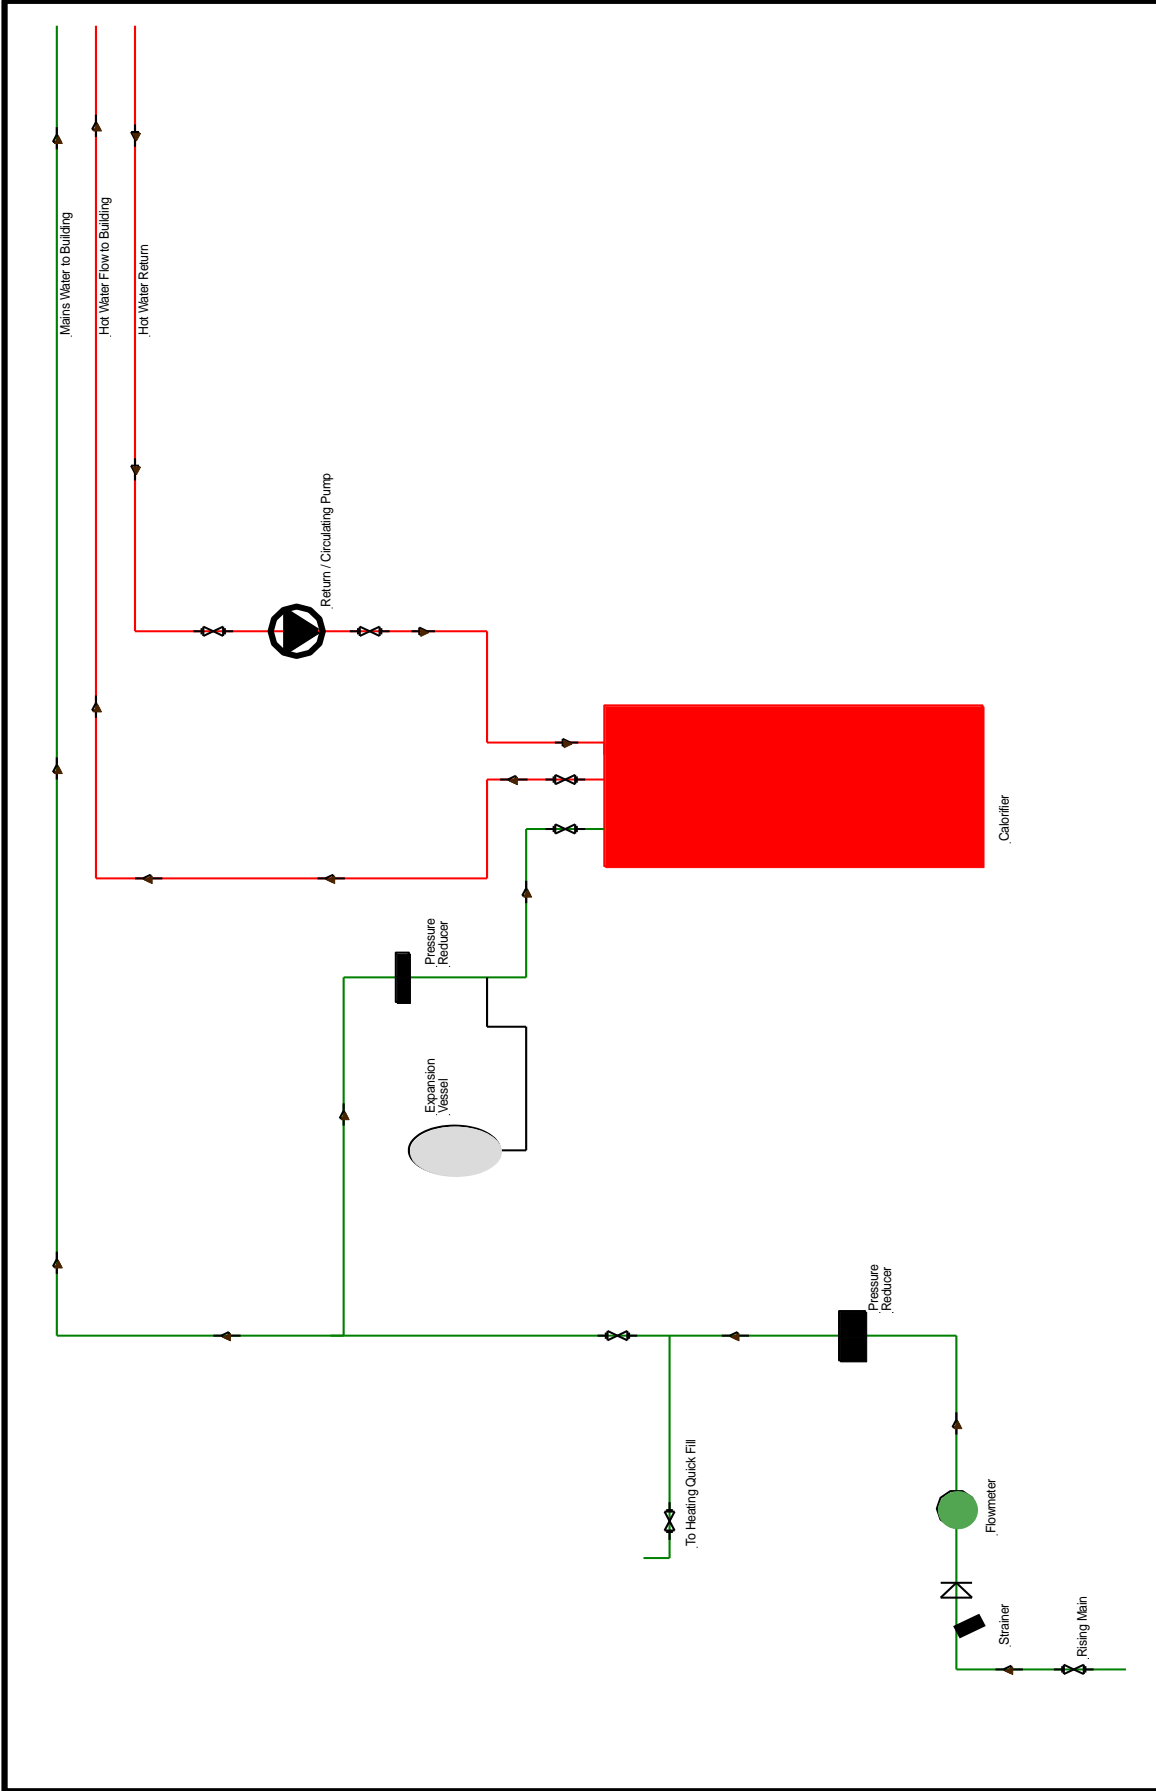

**Site Reference / Date**  
 Woolston Community Centre  
 Domestic Water System  
 Boiler Room Area  
 16th January 2017


**Freeston Water Treatment**  
 Lulworth Business Centre  
 Calmore Industrial Estate  
 Totton Southampton  
 SO40 3WW  
 Tel: 02380669713

**FREESTON**  
 Water Treatment

This drawing was prepared for the Legionellosis Risk Assessment Report and not intended as a scaled system drawing. It is a schematic diagram of the system and does not show the actual layout of the pipes. Some areas of pipe work may not have been visible during the survey therefore some assumptions may have been made in order to create this drawing.  
**This drawing is not to scale**

**LEGEND**

.WM = Washing Machine	DW = Dishwasher	.Mains Water
.WB = Wash Basin	.UR = Urinal	.Down Service
.SK = Sink	.WH = Water Heater	.Hot Water
.WC = Toilet	.POUMH = Point Of Use Water Heater	.Softened Water
.SH = Shower	.TMV = Thermosstatic Mixing Valve / Blender Valve	

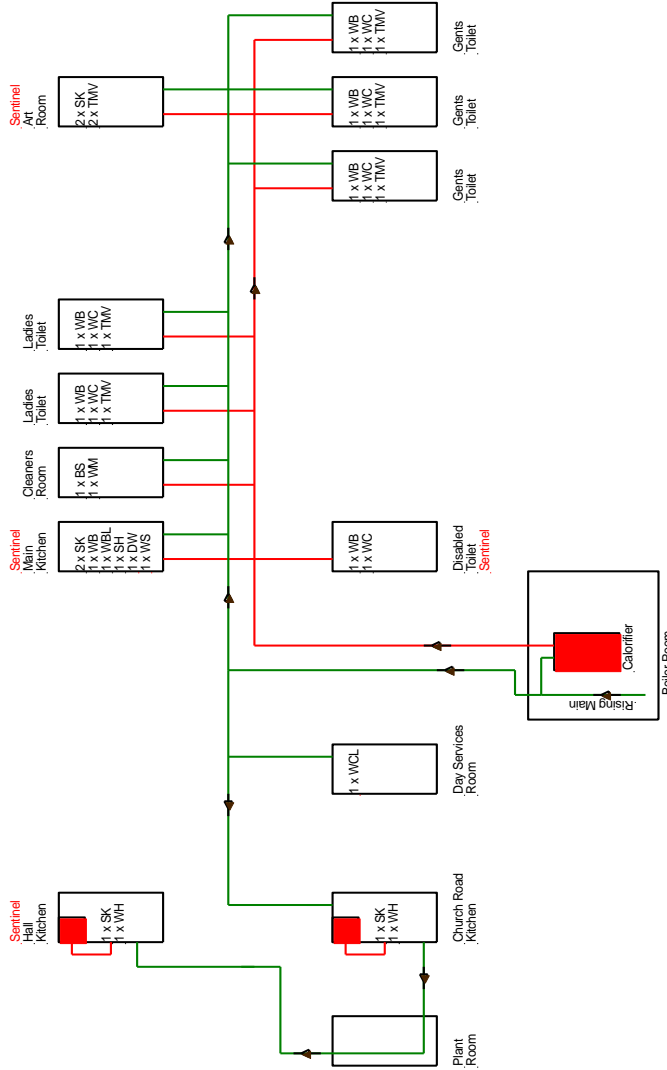

**LEGEND**

- .WM = Washing Machine
- .WB = Wash Basin
- .SK = Sink
- .WC = Toilet
- .SH = Sprayhead
- .DW = Dishwasher
- .UR = Urinal
- .WH = Water Heater
- .POUWH = Point Of Use Water Heater
- .TMV = Thermostatic Mixing Valve / Blender Valve
- .WCL = Water Cooler
- .WS = Water Softener
- .WH = Water Heater
- .POUWH = Point Of Use Water Heater
- .TMV = Thermostatic Mixing Valve / Blender Valve

- Mains Water
- Down Service
- Hot Water
- Softened Water

This drawing was prepared for the Legionellosis Risk Assessment Report and not intended as a scaled system drawing. It is based on the information provided during the Risk Assessment and is not a guarantee of the accuracy of the drawing. Some areas of pipe work may not have been viable during the survey therefore some assumptions may have been made in order to create this drawing.

 











This drawing is not to scale



Freeston Water Treatment  
 Lulworth Business Centre  
 Lulworth Industrial Estate  
 Totton Southampton  
 SO40 3WV  
 Tel: 02380669713

Site Reference / Date  
 Woolston Community Centre  
 Building Domestic Water Layout  
 16th January 2017

**KEY**

-  Ball A Fix Valve
-  Check Valve
-  Laboratory Tap
-  Blender Valve
-  Pump
-  Isolating Valve
-  Safety Valve
-  Drinking Fountain
-  Shower
-  Mains Water Service
-  Cold Water Down Service
-  Hot Flow/Return


**NOTE**

This drawing was prepared for the Legionellosis Risk Assessment Report and not intended as a scaled system drawing.  
Drawings are based on a visual inspection carried out during the Risk Assessment and information given at the time of the survey.  
Some areas of pipe work may not have been visible during the survey therefore some assumptions may have been made in order to create this drawing.  
This drawing is not to scale.

**Freston Water Treatment**  
Unit 1  
Lulworth Business Centre  
Calmore Industrial Estate  
Totton Southampton  
SO40 3WW  
Tel 02380669713

Site Ref  
Woolston Community Centre  
Pre-School

Date 21st January 2015  
Drawing No.1

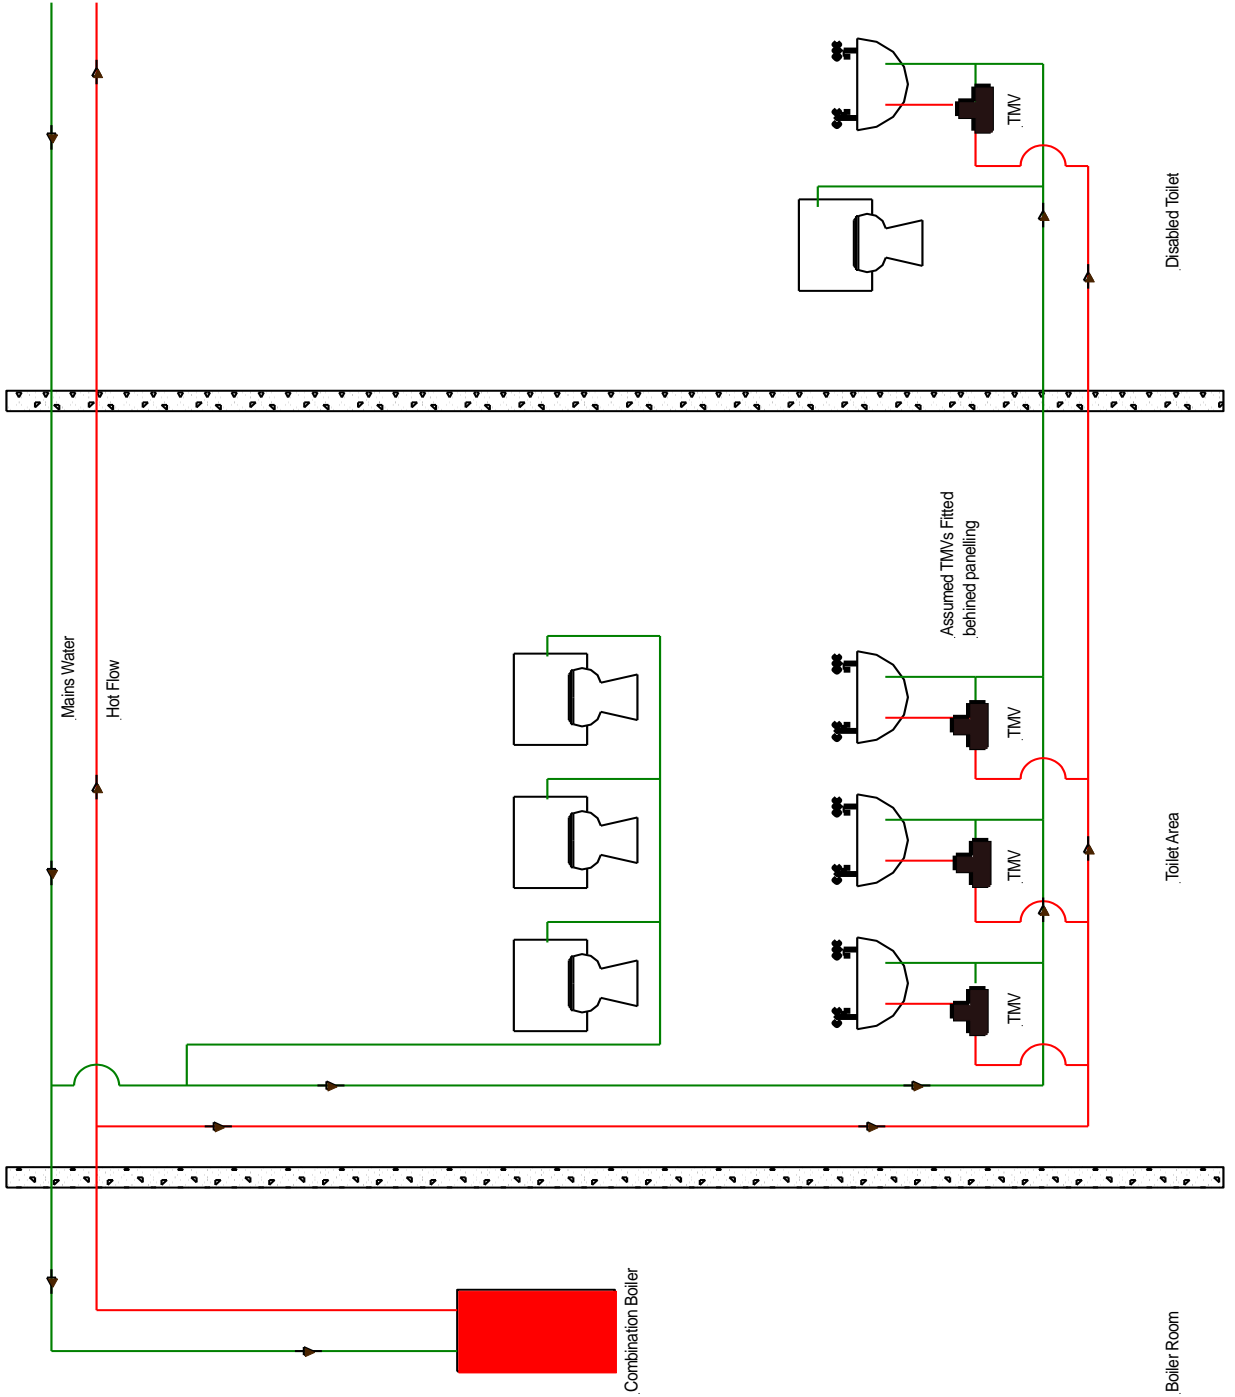

**KEY**

- Ball A Fix Valve
- Check Valve
- Laboratory Tap
- Blender Valve
- Pump
- Isolating Valve
- Safety Valve
- Drinking Fountain
- Shower
- Mains Water Service
- Cold Water Down Service
- Hot Flow/Return

**NOTE**

This drawing was prepared for the Legendloss Risk Assessment Report and not intended as a scaled system drawing.  
Drawings are based on a visual inspection carried out during the Risk Assessment and information given at the time of the survey.  
Some areas of pipe work may not have been visible during the survey therefore some assumptions may have been made in order to create this drawing.  
This drawing is not to scale.

**Freeston Water Treatment**  
Unit 1  
Lulworth Business Centre  
Calmore Industrial Estate  
Totter Southhampton  
SO40 3WW  
Tel 02380669713

Site Ref  
Woolston Community Centre  
Pre-School

Date 21st January 2015

Drawing No.2

