


**YMCA Sure Start Nursery
Townhill Park**

**Water System Drawings
19th November 2018**

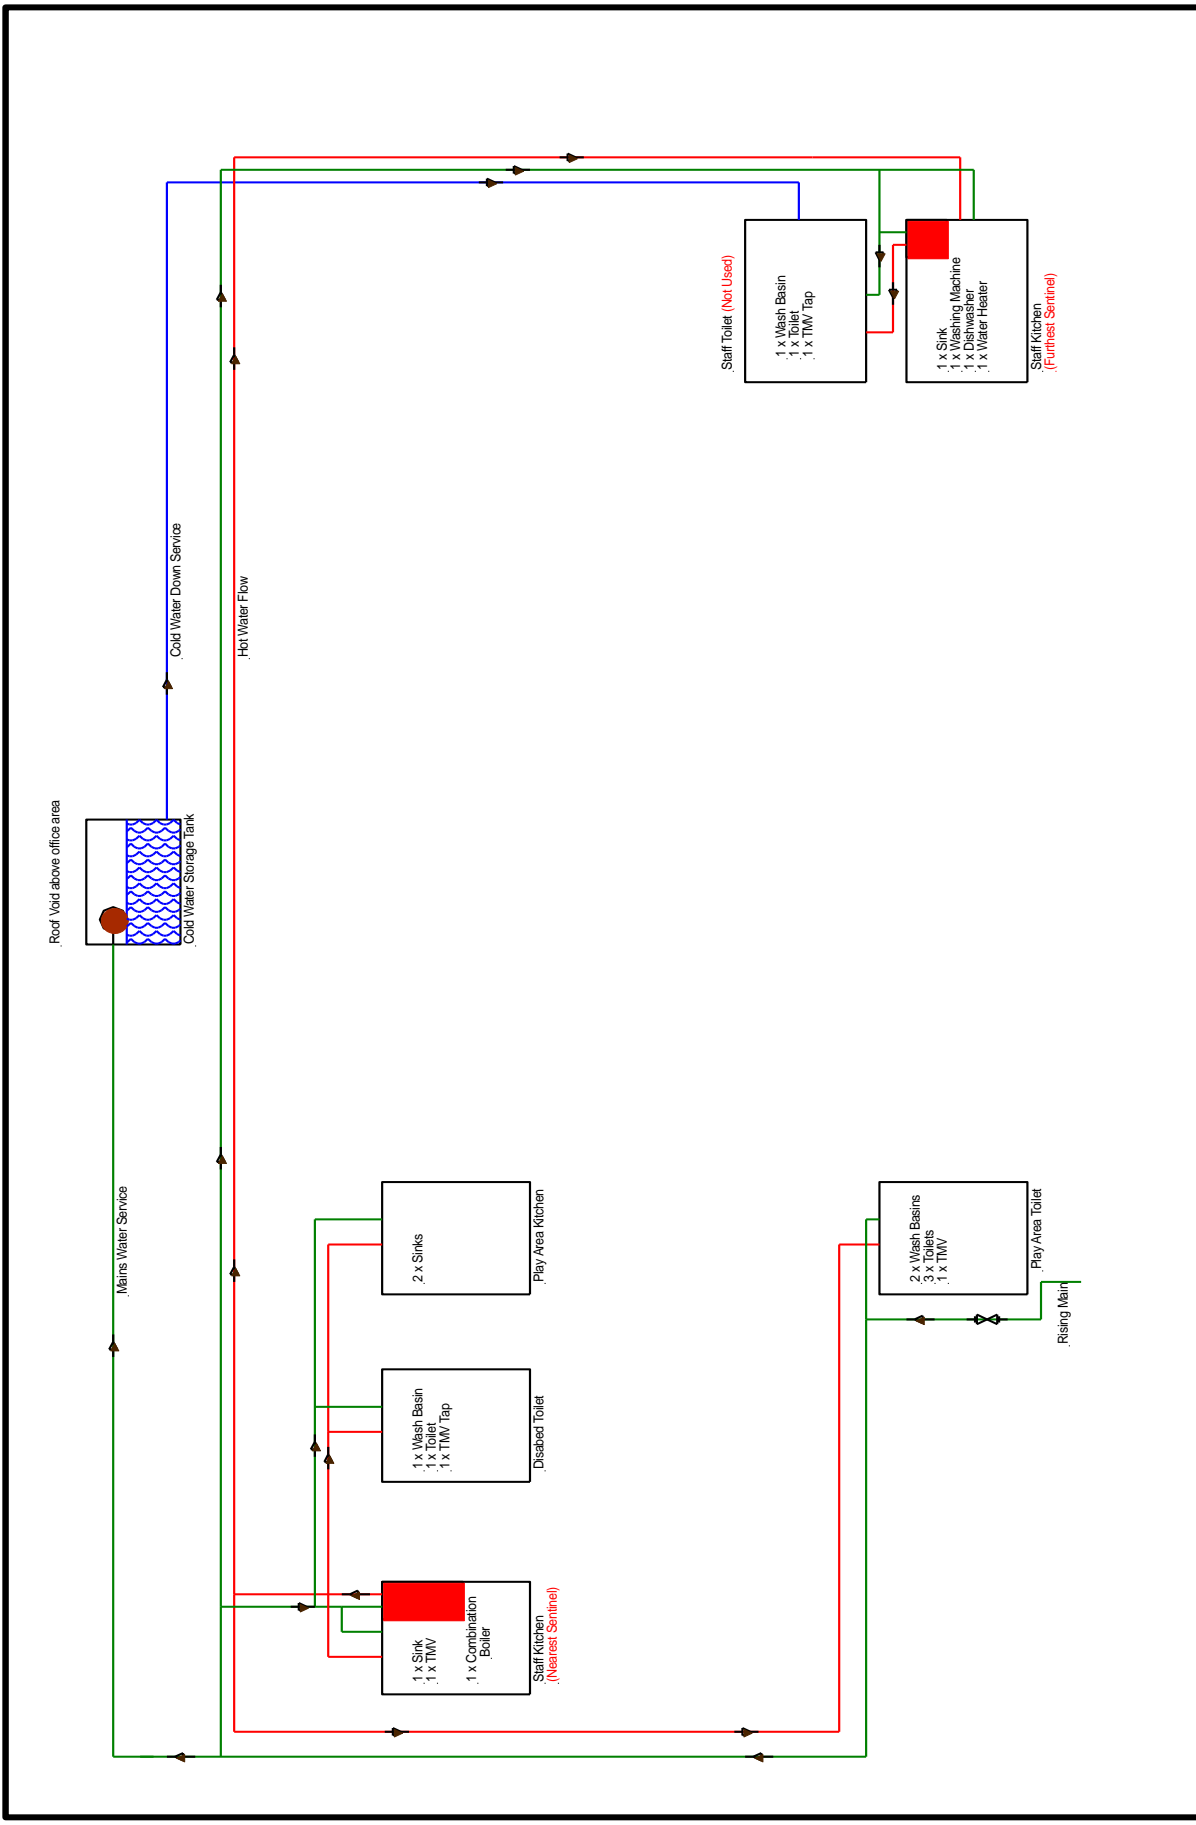

LEGEND

- WM = Washing Machine
- WB = Wash Basin
- SK = Sink
- WC = Toilet
- SH = Shower
- DW = Dishwasher
- UR = Urinal
- WH = Water Heater
- POUWH = Point Of Use Water Heater
- TMW = Thermostatic Mixing Valve / Blender Valve

Color Key:

- Green line: Mains Water
- Blue line: Down Service
- Red line: Hot Water
- Light Green line: Softened Water

Notes:

- This drawing was prepared for the Legionellosis Risk Assessment Report and not intended as a scaled system drawing. Drawings are based on a visual inspection carried out during the Risk Assessment and information given at the time of the survey. Therefore some assumptions may have been made in order to create this drawing.
- This drawing is not to scale

Freeston Water Treatment
 Unit 1
 Ujorah Business Centre
 Colchester Estate
 Totton Southampton
 SO40 3MW
 Tel 02380689713

Site Reference Date
 YMCA Townhill Nursery
 Domestic Water System Layout
 18th November 2018